

Mr Thomas Freeman
Development Director
Alanna Roadbridge Joint Venture Partnership
4 The Mall
Main Street
Lucan
Co. Dublin

1 February 2021

Re: Letter of consent for Alanna Roadbridge Joint Venture Partnership to undertake works on Westmeath County Council owned lands at Lisseywollen, Athlone.

Dear Mr. Freeman,

Westmeath County Council consent to Alanna Roadbridge Joint Venture Partnership including lands at Lisseywollen, Athlone, Co. Westmeath in their planning application. These lands, being that part of lands:


- registered to Westmeath County Council under folio reference's, WH6918F, WH12150, WH1231, WH7923, WH848, WH10289F, WH23881F, WH19651, WH556, WH547, WH555, WH20040, and WH10636.
- in sale to Westmeath County Council under folio reference's, WH10173, WH19579F
- in sale to Westmeath County Council, 1.045 acres of unregistered land at Kilnafadoge Townland, Athlone,

are displayed on the attached drawing number, **106-02-001LF** and depicted within the red line of the site boundary.

This letter of consent is solely to facilitate the making of the planning application, is without prejudice to the Council's consideration or determination of such planning application or to the Council's requirements in relation to the use and re-instatement of our said lands in the event that the proposed development may be permitted and does proceed.


This letter of consent, which will expire two calendar years from the date on this letter, confers no other rights whatsoever to any party.

Yours sincerely,



Pat Gallagher
Chief Executive

Designated Public Official under the Regulation of Lobbying Act

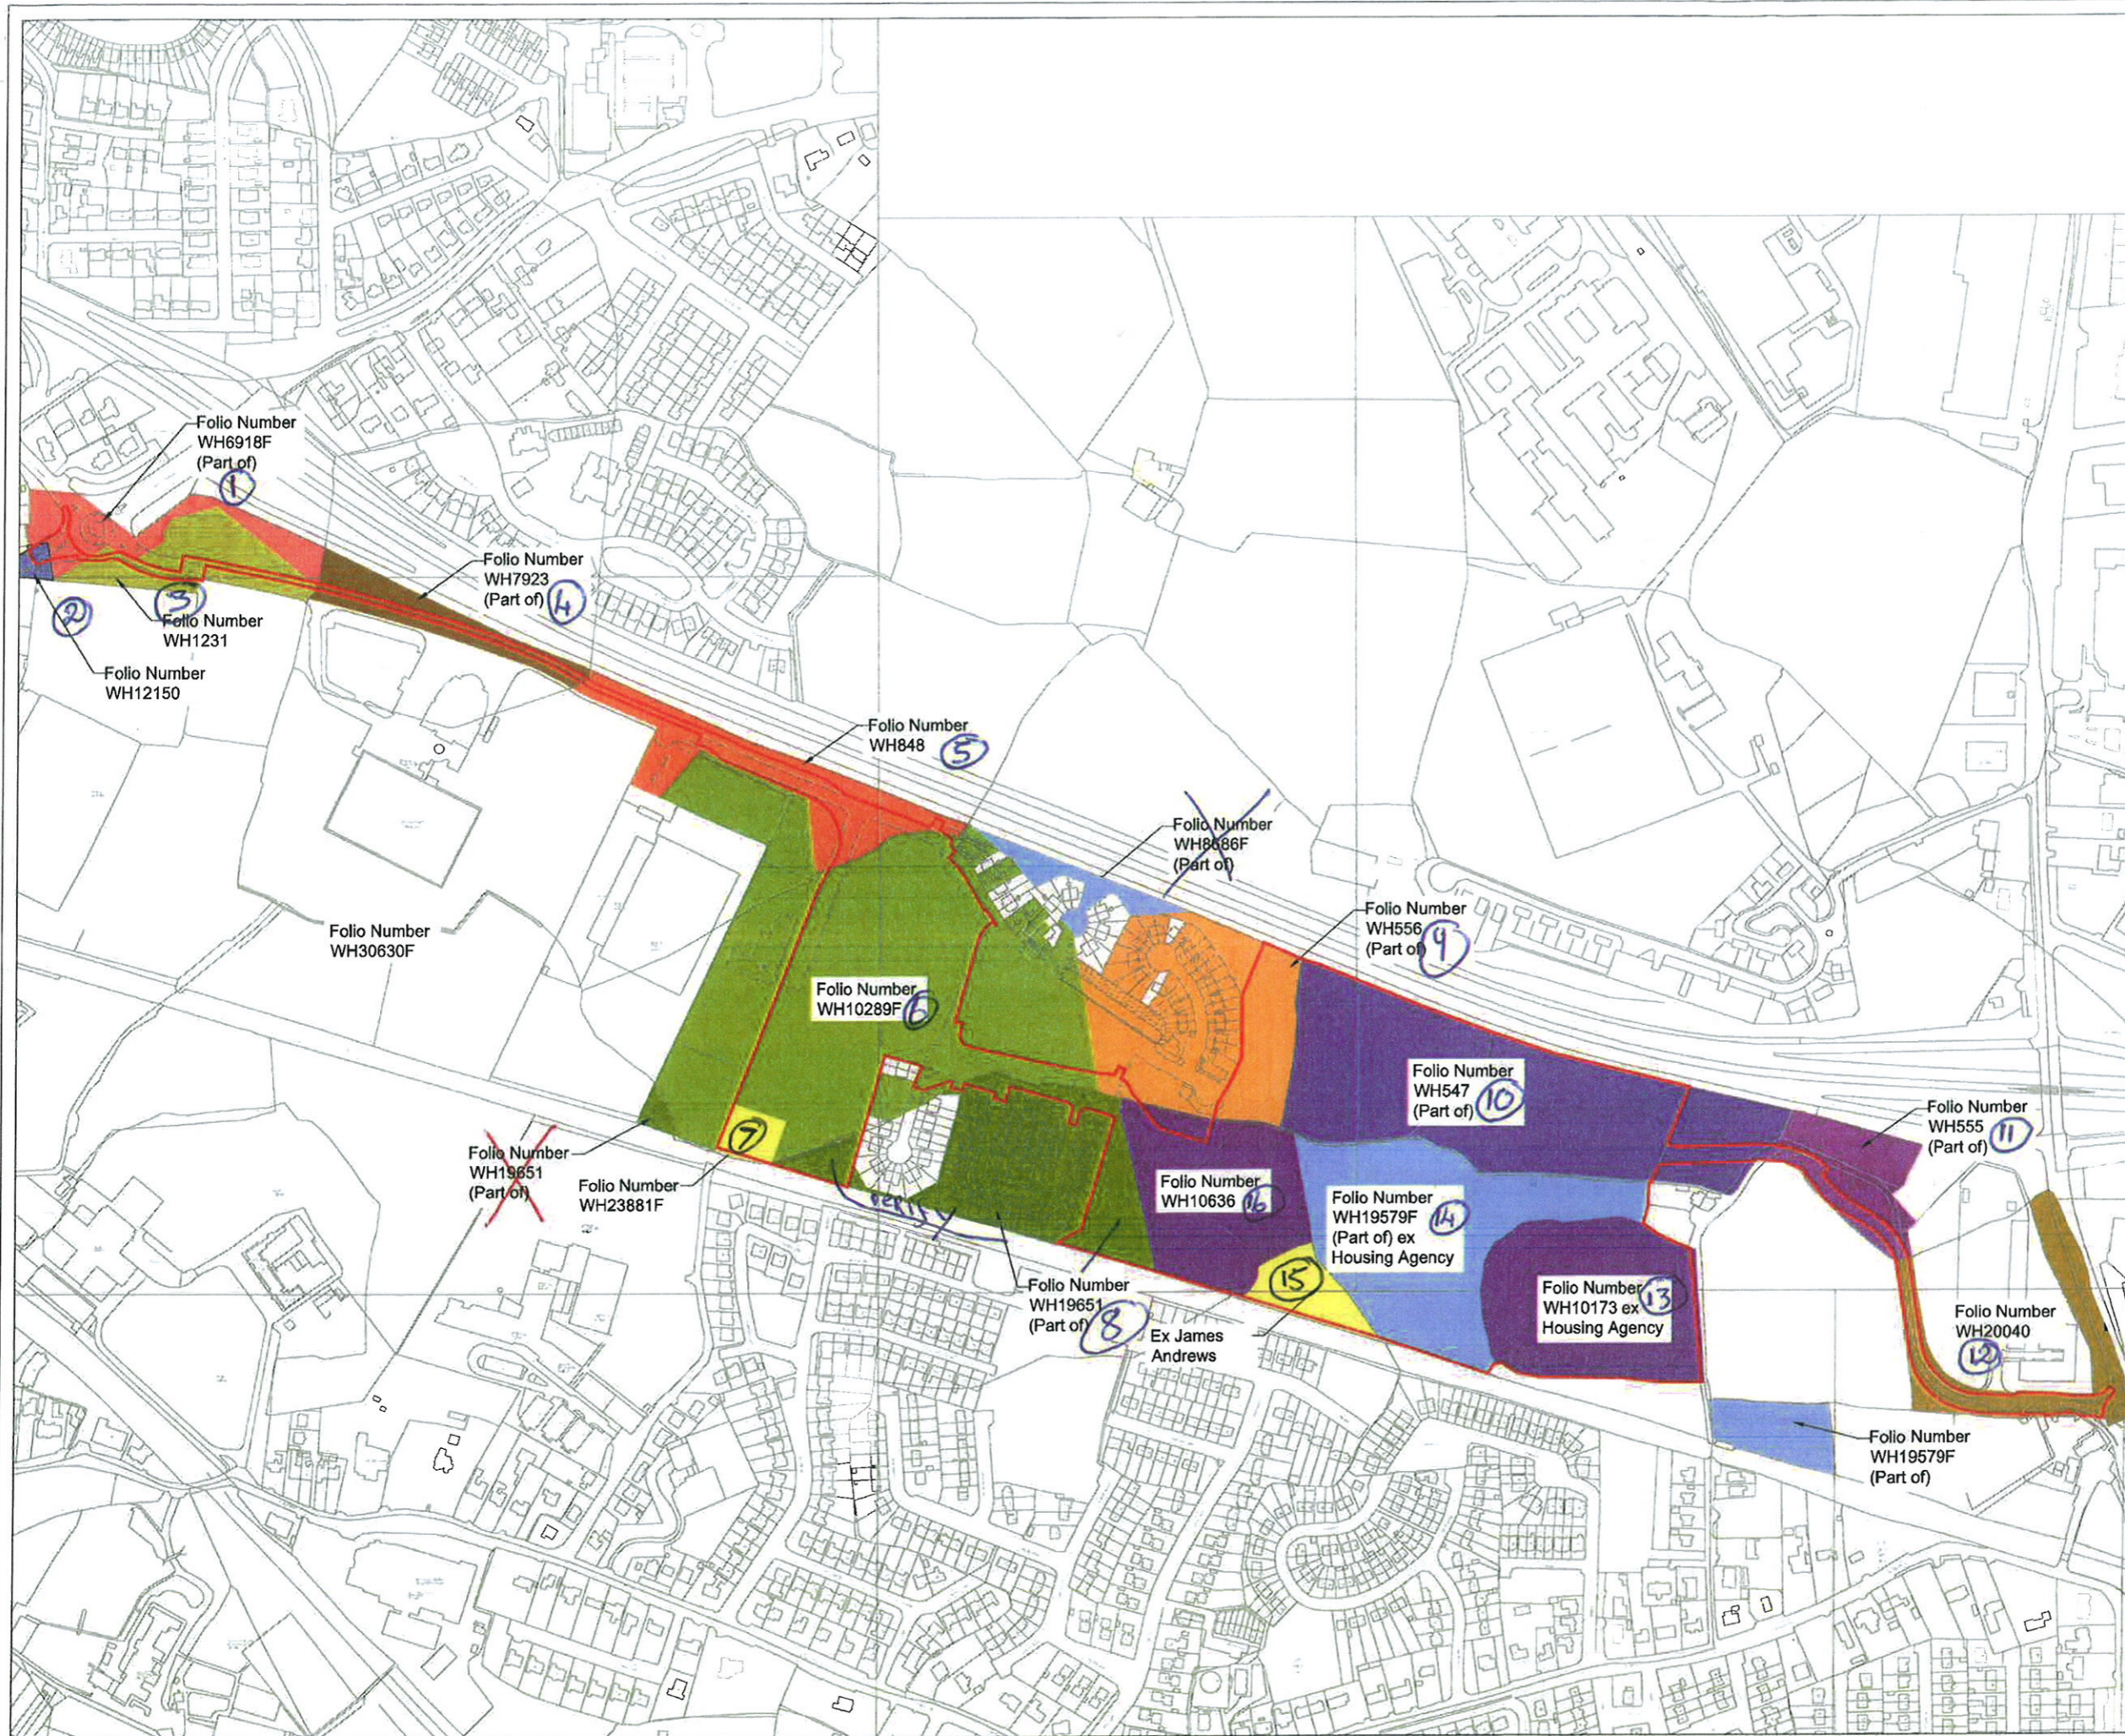

REV.	DESCRIPTION	DATE	BY


Funded by the Irish Government under Rebuilding Ireland, Action Plan for Housing and Homelessness


WESTMEATH HOUSING DESIGN TEAM
 WESTMEATH COUNTY COUNCIL,
 CIVIC CENTRE, CHURCH ST.,
 ATHLONE, N37 P2T5
 Phone: 0906442100
 Web: www.westmeathcoco.ie

PROJECT: Lissywollen LIHAF

TITLE: Land Folio within Red Line Boundary

Scale: 1:2500	Datum: MALIN	Date: 16/12/2020
Drawing No. 106_02_001LF	Stage: PLANNING	Revision
Surveyed	Drwn	Checked
N/A	MK	* P1
		PH

FILE NAME AND DIRECTORY:
 Lissywollen_Land Ownership_2018.dwg
 PROJECT CAPITAL HOUSING DESIGN TEAM - Capital Schemes/106-Brady Athlone Drawings