
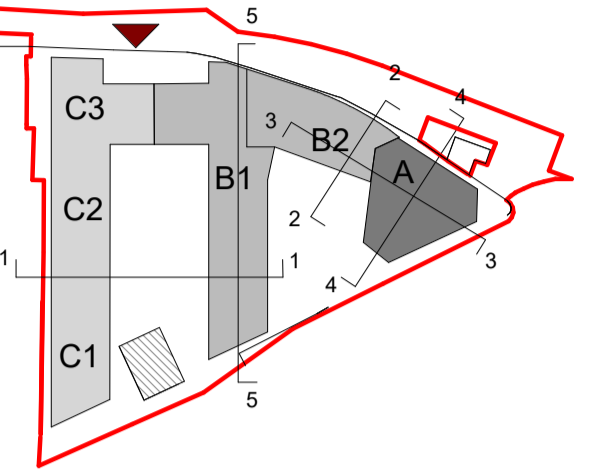


Notes:
DO NOT SCALE FROM THIS DRAWING. USE FIGURED DIMENSIONS
IN ALL CASES. VERIFY DIMENSIONS ON SITE AND REPORT ANY
DISCREPANCIES TO THE ARCHITECTS IMMEDIATELY. THIS
DRAWING TO BE READ IN CONJUNCTION WITH THE ARCHITECTS
SPECIFICATION. © THIS DRAWING IS COPYRIGHT AND MAY ONLY
BE REPRODUCED WITH THE ARCHITECTS PERMISSION.

OSI License Number - AR 0052219
Projection / Spatial Reference:
Projection= IRENE195_msh_Transverse_Mercator
Centre Point Coordinates:
X,Y= 713657.3699,734403.2446
Reference Index:
Map Series | Map Sheets
1:1,000 | 3263-02
1:1,000 | 3263-06
1:1,000 | 3263-07
1:1,000 | 3263-03
Vertical Datum:
MALIN HEAD

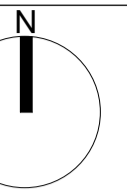

PLANNING LEGEND

SYMBOL	DESCRIPTION
[Red line]	SITE BOUNDARY LINE
[Grey area]	EXISTING STRUCTURES
[Yellow area]	WAYLEAVE / RIGHT OF WAY
[Green triangle]	RESIDENTIAL ENTRANCE
[Orange triangle]	PUBLIC ENTRANCE

Materials Legend

No.	DESCRIPTION
1	SELECTED LIMESTONE
2	SELECTED DARK BRICK
3	SELECTED LIGHT BRICK
4	DARK STONE PANEL
5	SELECTED METAL CLADDING
6	ALUMINIUM SHOP FRONT
7	ALUMINIUM COMPOSITE WINDOWS
8	DARK RENDER
9	LIGHT RENDER
10	SELECTED CURTAIN WALLING
11	GLAZED HANDRAIL

As permitted under ABP Reg. Ref 306569-20

PO2	27/01/20	EOB	Full Planning ABP issue
PO1	14/06/19	EOB	Pre-Planning ABP issue

Rev	Date	DRN	Description


Reddy Architecture + Urbanism
Dartly Road
Dublin 6, D06 Y0E3
T: +353 (0)1 4987000
W: www.reddyarchitecture.com
E: info@reddyarchitecture.com

Client Details:
Ruiside Developments Ltd.

Project Details:
PGATE
42A Parkgate Street, Dublin 8

Drawing Title:
Permitted North Elevation
ABP Ref. 306569-20

Job No P18-107D	Date 27/01/20	Scale@A1 1:200
Status Planning	Drawn By M.McGuire	
Purpose Planning Permission	Checked By E.O'Brien	
Drawing Number PGATE-RAU-ZZ-ZZ-DR-A-ELE-32201	Revision P02	

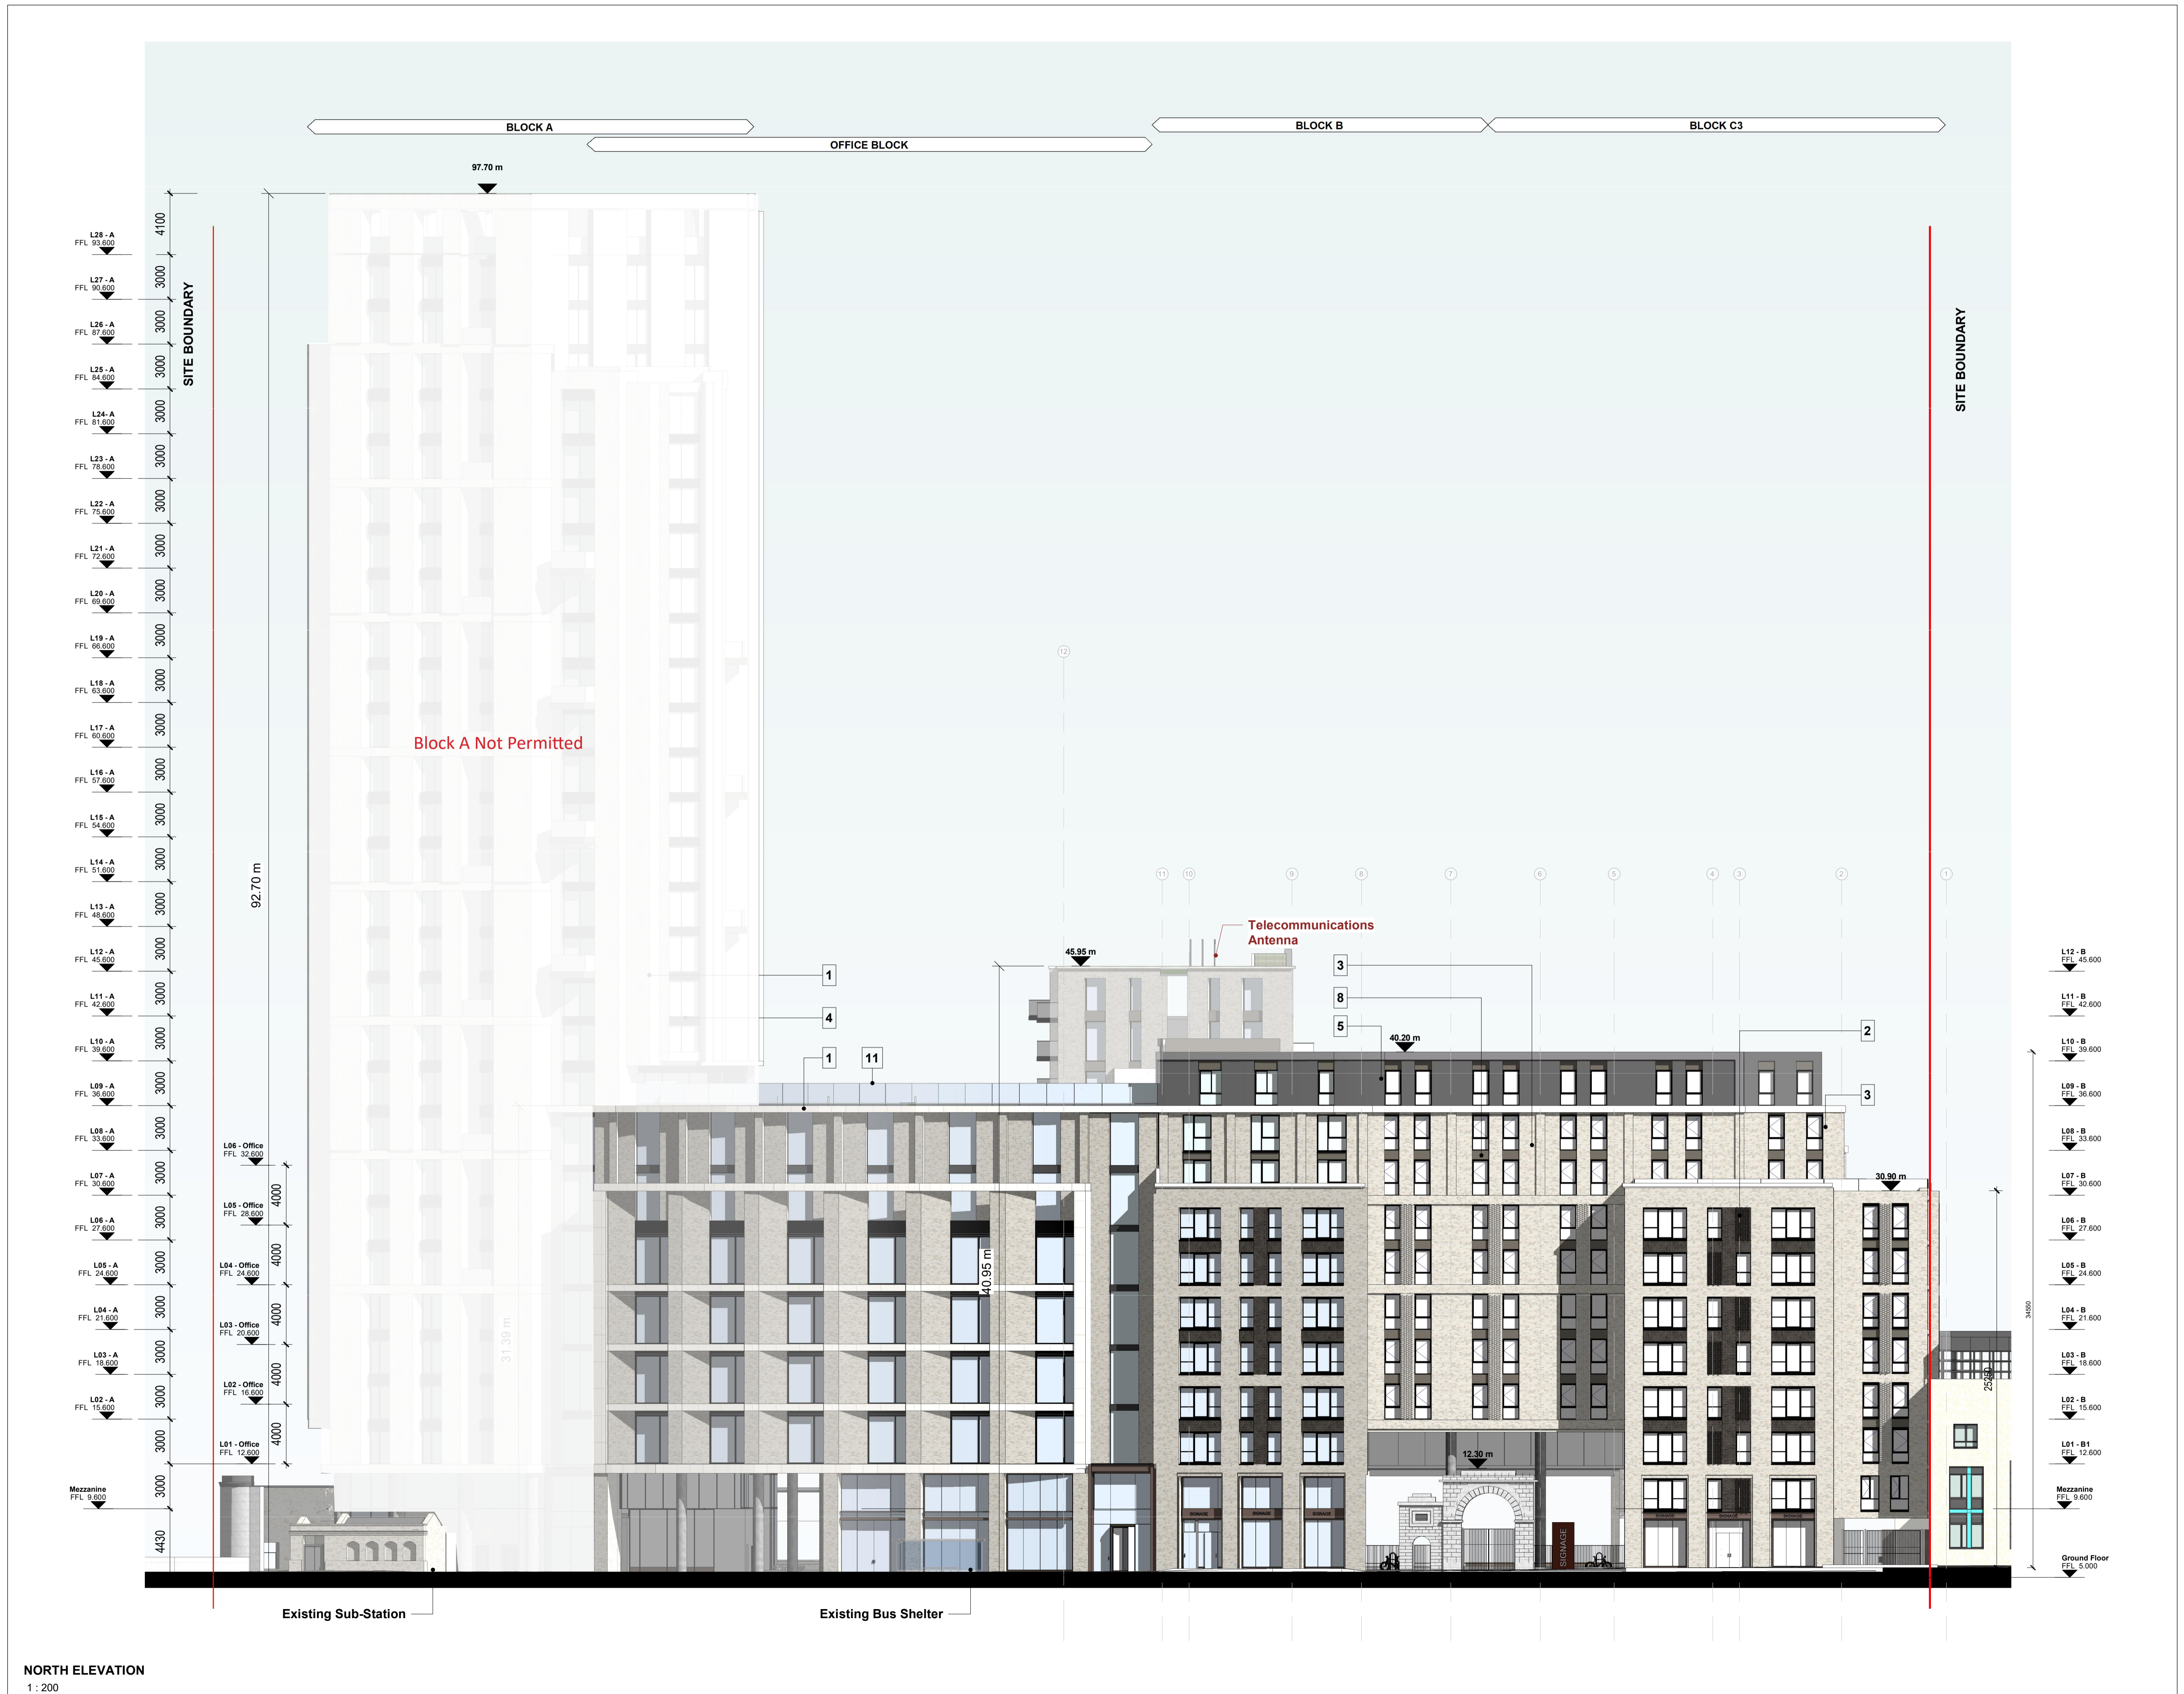

NORTH ELEVATION
1 : 200