


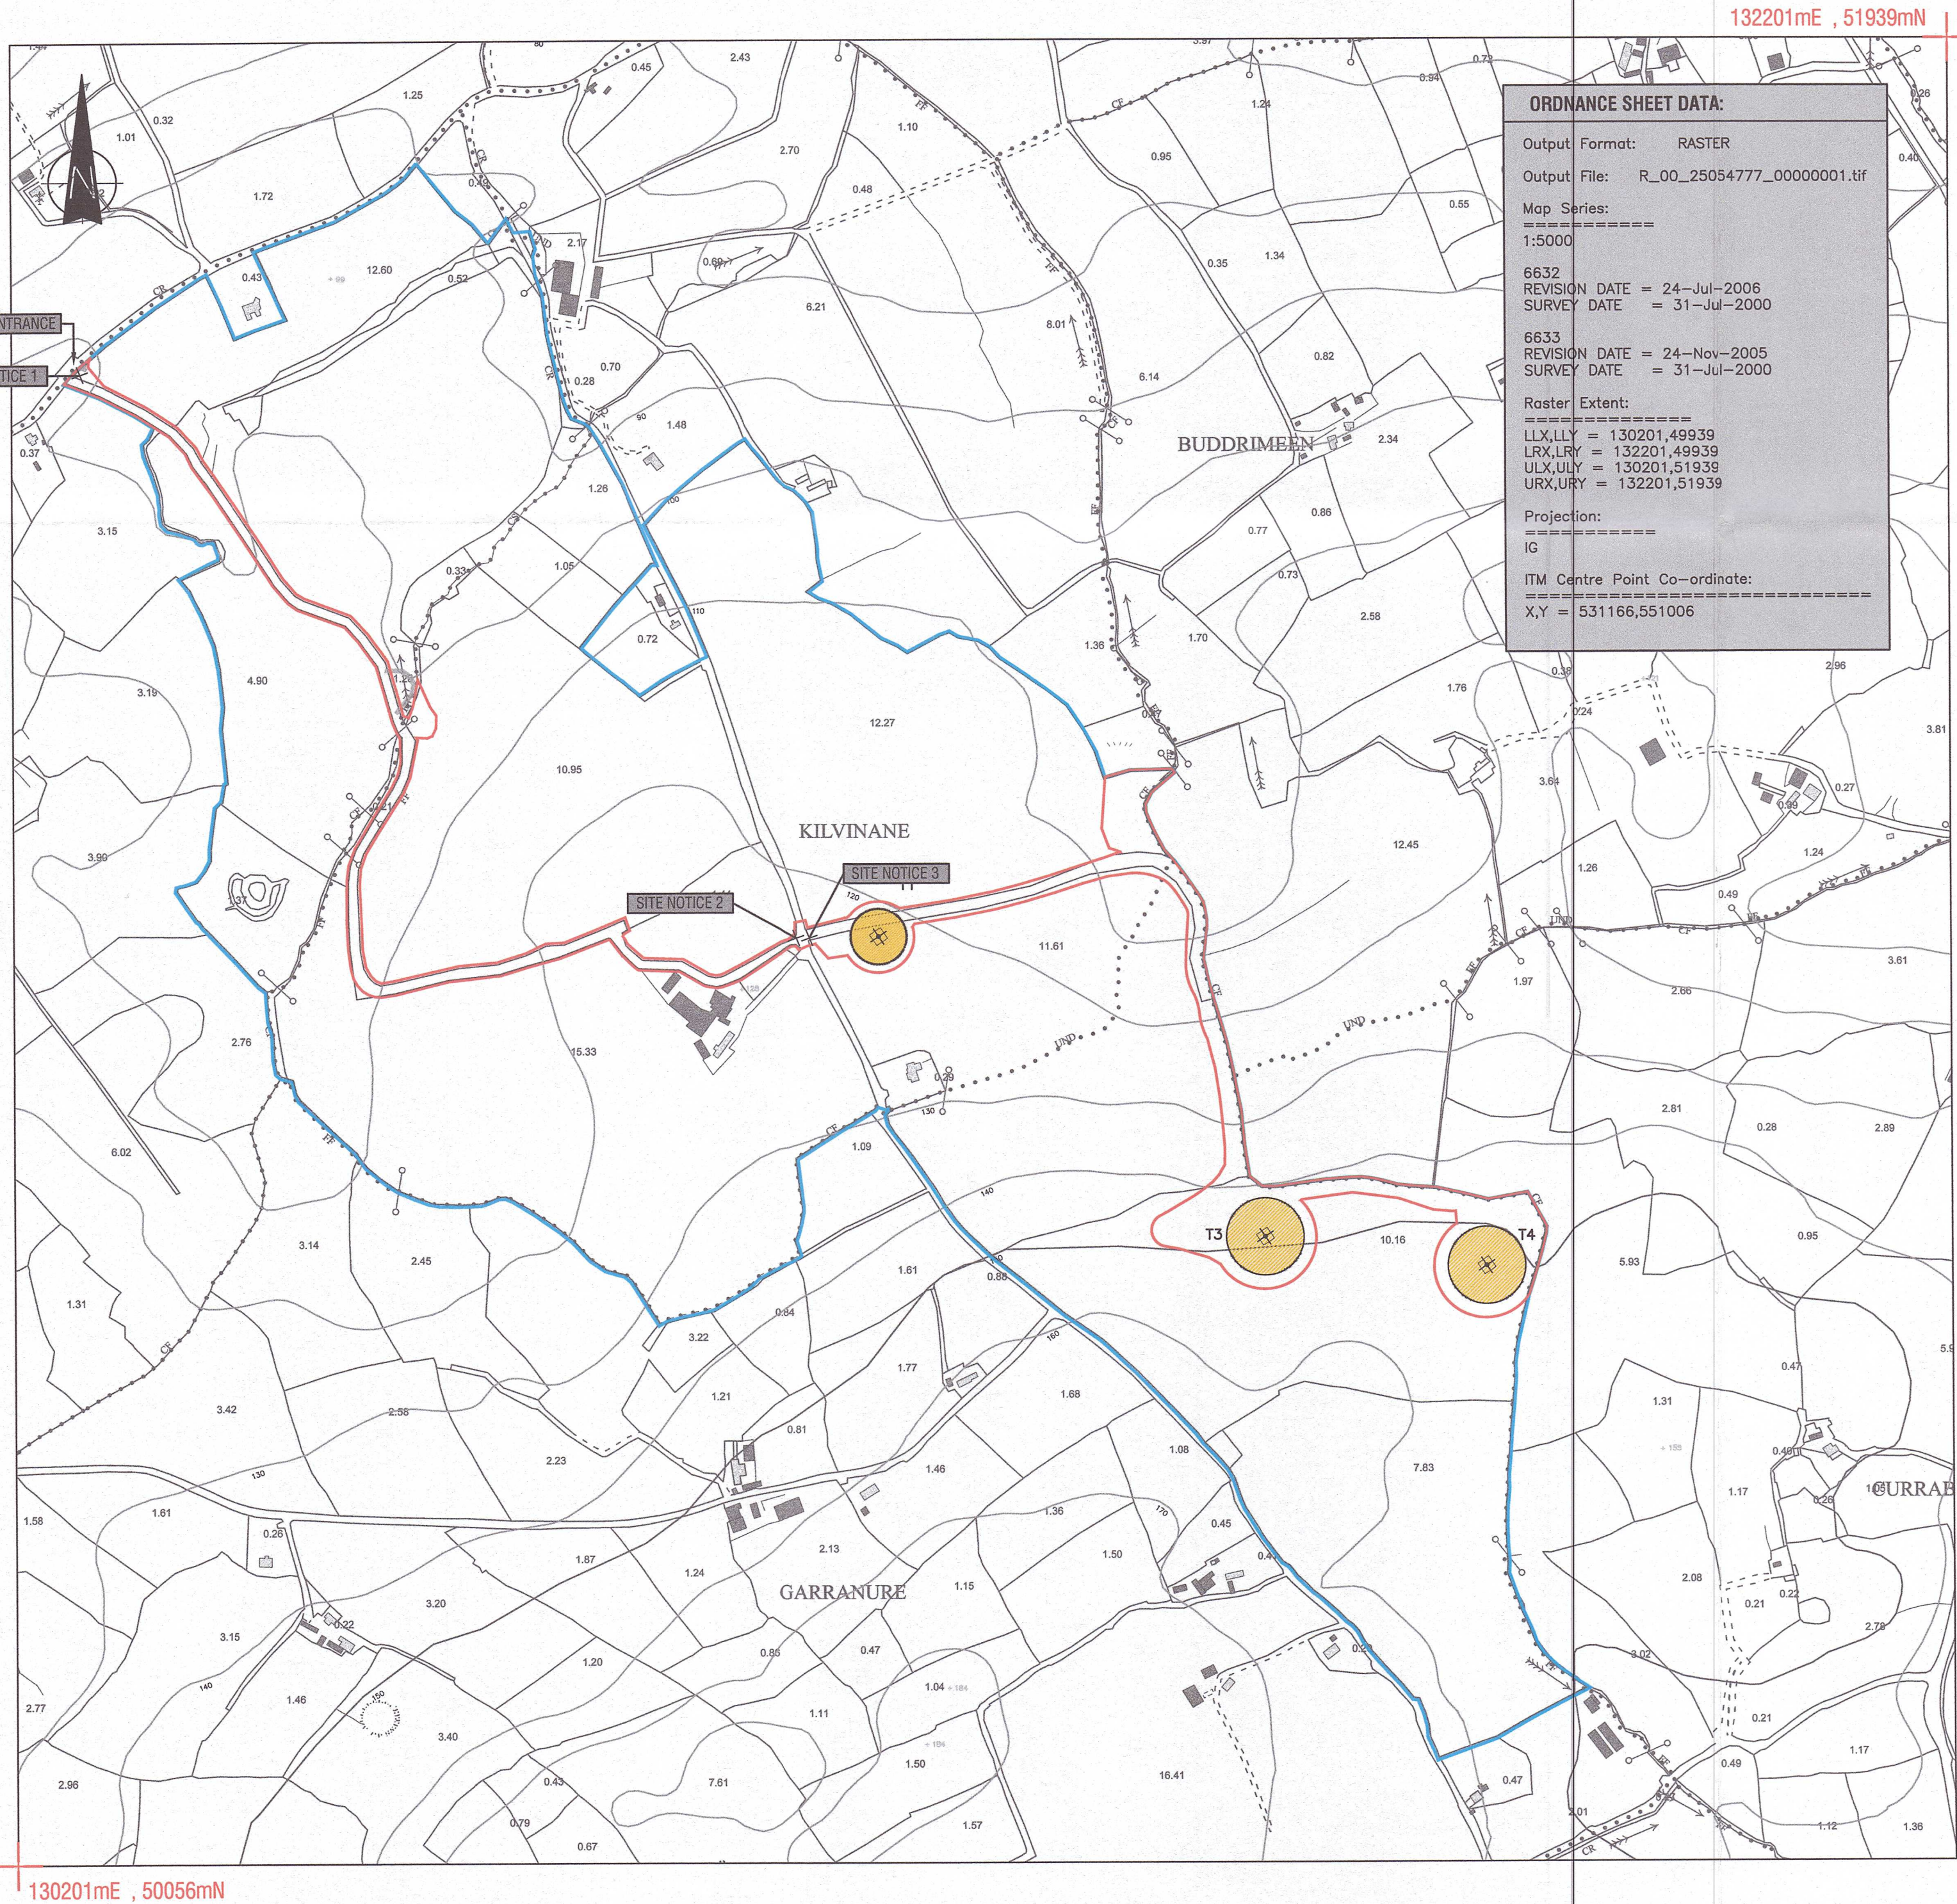

ORDNANCE SHEET DATA:

Output Format: RASTER
Output File: R_00_25054777_00000001.tif

Map Series:
=====

1:5000

6632
REVISION DATE = 24-Jul-2006
SURVEY DATE = 31-Jul-2000

6633
REVISION DATE = 24-Nov-2005
SURVEY DATE = 31-Jul-2000

Raster Extent:
=====

LLX,LLY = 130201,49939
LRX,LRY = 132201,49939
ULX,ULY = 130201,51939
URX,URY = 132201,51939

Projection:
=====

IG

ITM Centre Point Co-ordinate:
=====

X,Y = 531166,551006

Notes :

1. All dimensions are in millimetres – figured dimensions to be taken in preference to scaled dimensions.
2. All levels are in metres and relate to Ordnance Datum Malin Head.

Legend :-

- Overall Site Boundary shown thus: 
(Overall Site Area = 96.5ha)
- Windfarm Development Boundary shown thus: 
(Development Area = 6.92ha)
- 50m Contour shown thus:  250
- 10m Contour shown thus:  270

REG. No.
PLANNING (WEST) DEPT
29 SEP 2023
CORK COUNTY COUNCIL
SKIBBEREEN, Co. CORK P81 AT2E

Ordnance Survey Ireland Licence No. EN 0034811
Ordnance Survey Ireland Government of Ireland

Issue	Date	Revisions	Drawn	Checked	Approved
1	5.8.22	'As-Built' – Permitted Development Issue	DM	KH	KH
O	2.10.15	Original	DM	KH	KH

MRG
consulting engineers

1202 Gateway Business Park, Mallow Rd, Cork
Telephone : (021) 4300250
Telefax : (021) 4306733
E-Mail : cork@mrg.ie
also : Day Place, Tralee, Co. Kerry

MRG Consulting Engineers CIVIL STRUCTURAL ENVIRONMENTAL

Project
KILVINANE WINDFARM – CO. CORK

Drawing
**As-Constructed Permitted Development
Site Location Map**

Drawn D.Moriarty	Project No. 122004	Drawing No. 122004-301B
Date 2.10.2015		
Scale 1:5,000 @ A2		